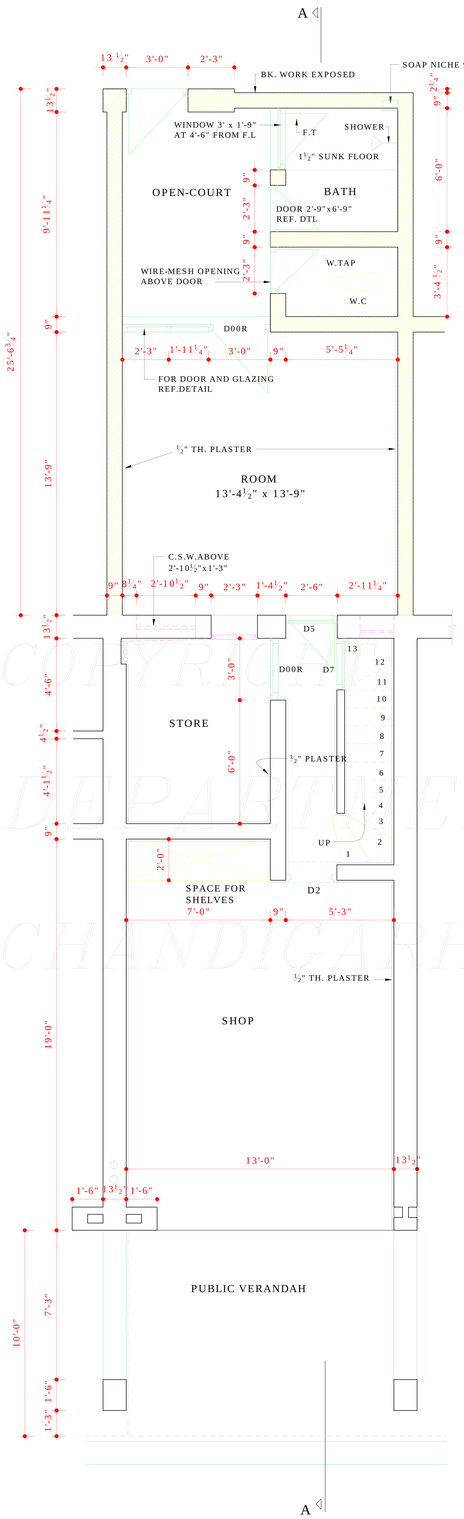

GROUND FLOOR PLAN

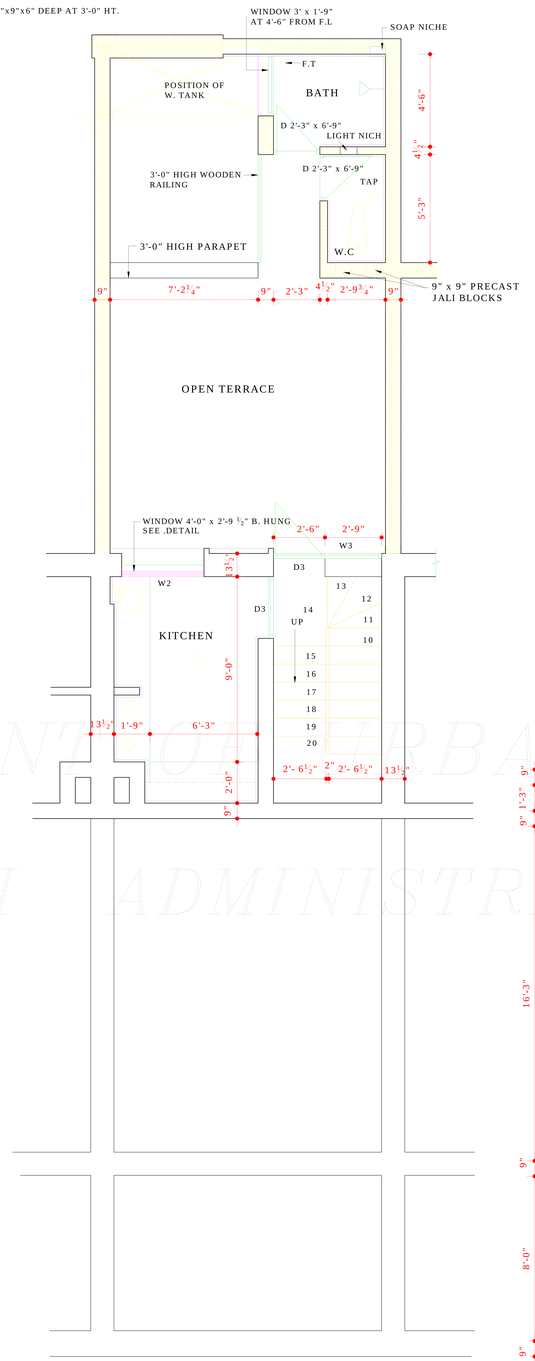

INTER FLOOR PLAN

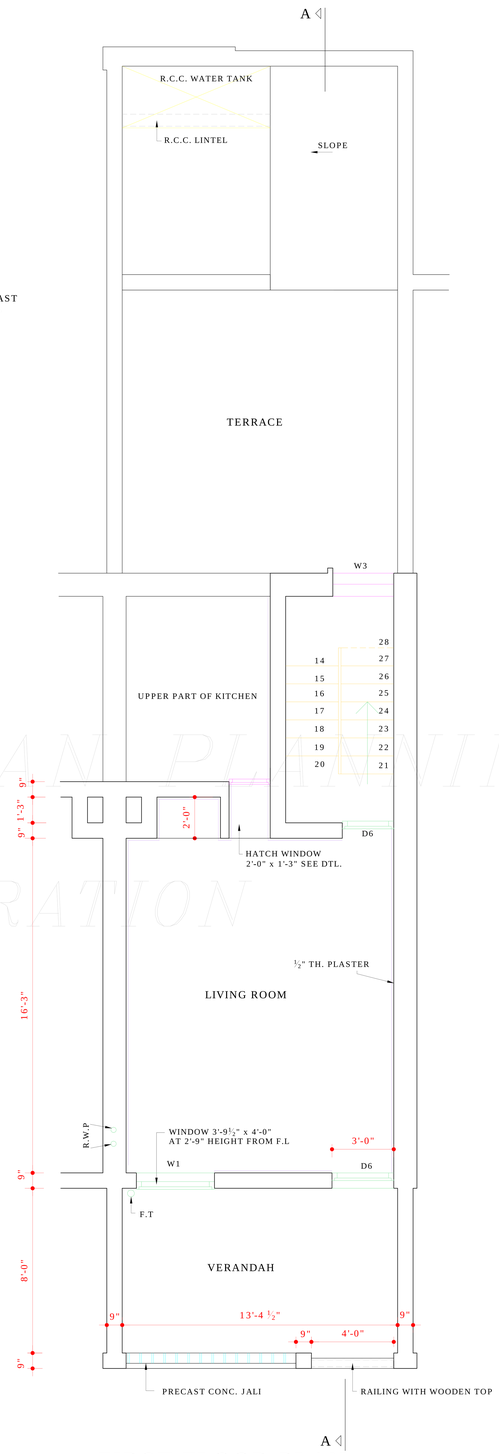

FIRST FLOOR PLAN

DISCLAIMER

THOUGH EVERY CARE HAS BEEN TAKEN TO PROVIDE THE CORRECT VERSION OF THE ARCHITECTURAL CONTROL ON THIS DIGITIZED (PDF) FORMAT, YET IN CASE OF ANY DISCREPANCY, THE MASTER COPY OF THE ARCHITECTURAL CONTROL APPLICABLE ON EACH SUCH SITE, AS AVAILABLE IN THE COMMERCIAL RECORD OF THE OFFICE OF CHIEF ARCHITECT OR HER/HIS INTERPRETATION WILL OVERRULE THE DIGITIZED FORMAT.

COPYRIGHT
DEPARTMENT OF URBAN PLANNING
CHANDIGARH ADMINISTRATION

DEPARTMENT OF ARCHITECTURE

S.NO.	NOTES
1	THIS DRG. IS THE PROPERTY OF THE DEPTT. OF ARCHITECTURE U.T. CHANDIGARH & MUST NOT BE ALTERED, COPIED OR USED IN WHOLE OR PART WITHOUT THE PERMISSION OF THIS DEPTT. IN WRITING.
2	PROPOSED CONSTRUCTION SHOWN IN RED.
3	EXISTING BUILDING SHOWN IN BLACK LINES.
*	AS PER CHIEF COMMISSIONERS ORDER DATED 15.3.71 ,REVISION MADE ON 26.7.71. REAR COURT YARD OPTIONAL PROVIDED IT IS IN CONFORMITY WITH THE BUILDING BY LAWS. SD- O.P. MEHTA

ATTESED TRUE COPY

ASSTT.ARCHITECT

Sd/- S.L. VERMA
26.10.70
CHIEF ADMINISTRATOR

NOTE:-
THIS DRAWING IS THE COMPUTERISED REPRODUCTION OF ORIGINAL DRG. NO. 12
JOB NO. 32/B DATE- 15-7-08

S.NO.	DESCRIPTION

REVISIONS

Sd/- M.N.SHARMA 26.10.70 CHIEF ARCHITECT	Sd/- J.S. DETHE SENIOR ARCHITECT
Sd/- R.S. LAL 11.1.67 ARCHITECT	Sd/- JAGDISH SINGH 11.1.67 ASSTT. ARCHITECT

OFFICE OF THE CHIEF ARCHITECT CHANDIGARH

SCALE :- 1" INCH = 4 FT.		DATE - 28.12.66
DRAWN - J.N. ARORA	JOB NO. 32-B	DRG NO. 12
CHECKED BY-		

SHOPPING CENTRE SECTOR- 16

PLANS SHOWING PROVISION OF W.C. & BATH ROOM AT INTER-FLOOR